


**NOTES:**  
 1. MATERIAL - 14 GA STEEL  
 2. FINISH - LIGHT GRAY POWDER COAT

THIS DRAWING IS FOR REFERENCE ONLY. IT IS A REPRESENTATION OF SPOHN DRAWING FSRHDG 641F-R. NOT TO BE USED FOR MANUFACTURE.

REV	DATE	BY	ECR	DESCRIPTION	APPR	REV	DATE	BY	ECR	DESCRIPTION	APPR
01	10/03/16	KY	378.952	UPDATED TO AS BUILT	DB						

<b>J.R. MERRITT CONTROLS</b> <small>THIS DOCUMENT CONTAINS DATA WHICH IS CONFIDENTIAL AND PROPRIETARY TO JRMCI INC. NO DISCLOSURE, REPRODUCTION, OR ANY USE OF ANY PART OF THIS DOCUMENT MAY BE MADE WITHOUT THE WRITTEN PERMISSION OF JRMCI INC.</small>	SCALE 1:2	CUSTOMER J.R. MERRITT CONTROLS, INC.
	DRAWN KY	DATE 06/09/15
CHECKED DB	DATE 10/05/16	DESCRIPTION FSRHDG 10" CONSOLE, RIGHT
APPROVED	DATE	DRAWING B15.101.8315R
		SHEET 1 OF 1
		REV 01

8315R

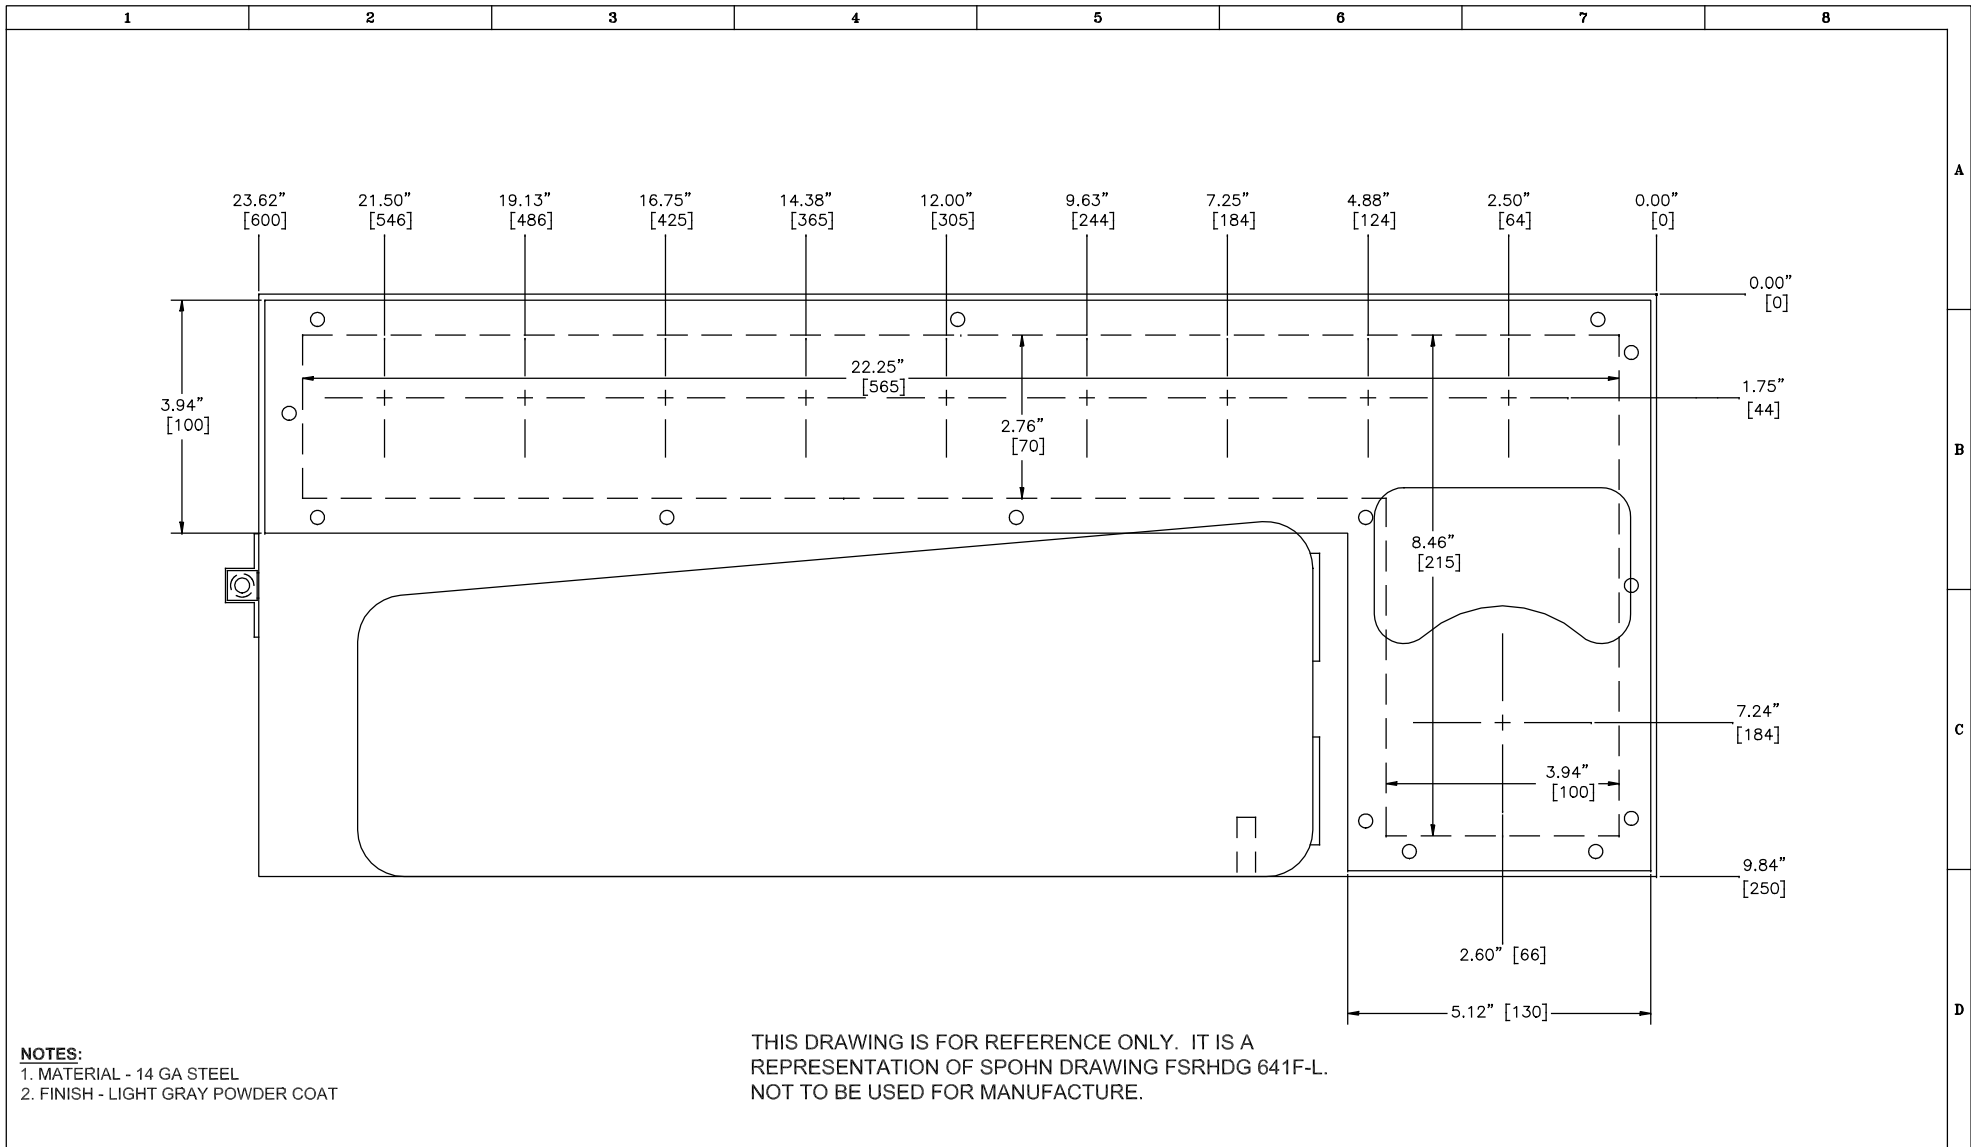

REV	DATE	BY	ECR	DESCRIPTION	APPR	REV	DATE	BY	ECR	DESCRIPTION	APPR
01	10/03/16	KY	378.952	UPDATED TO AS BUILT	DB						

<b>J.R. MERRITT CONTROLS</b> <small>THIS DOCUMENT CONTAINS DATA WHICH IS CONFIDENTIAL AND PROPRIETARY TO JRMC INC. NO DISCLOSURE, REPRODUCTION, OR ANY USE OF ANY PART OF THIS DOCUMENT MAY BE MADE WITHOUT THE WRITTEN PERMISSION OF JRMC INC.</small>	SCALE	CUSTOMER	J.R. MERRITT CONTROLS, INC.	
	1:2	DATE	QUOTE	REFERENCE
	DRAWN	06/09/15	PROJECT	
	KY			
CHECKED	DATE	DESCRIPTION	FSRHDG 10" CONSOLE, LEFT	
DB	10/05/16		DRAWING	B15.101.8315L
APPROVED	DATE	DRAWING	SHEET	REV
			1 OF 1	01

8315L