


THIS DRAWING IS FOR REFERENCE ONLY. IT IS A REPRESENTATION OF SPOHN DRAWING FSRHDG 653. NOT TO BE USED FOR MANUFACTURE.

- NOTES:**
 1. MATERIAL - 14 GA STEEL
 2. FINISH - LIGHT GRAY POWDER COAT

REV	DATE	BY	ECR	DESCRIPTION	APPR	REV	DATE	BY	ECR	DESCRIPTION	APPR
01	01/14/16	KY	160.120	CHANGED WIDTH FROM 11.8 TO 12"	DB						
02	10/03/16	KY	378.951	UPDATED TO AS BUILT	DB						

	SCALE	CUSTOMER	
	1:2	J.R. MERRITT CONTROLS, INC.	
DRAWN	DATE	QUOTE	PROJECT
KY	06/09/15		
CHECKED	DATE	DESCRIPTION	REFERENCE
DB	10/05/16	FSRHDG 12" CONSOLE, RIGHT	
APPROVED	DATE	DRAWING	SHEET
		B15.101.8314R	1 OF 1
			REV 02

8314R

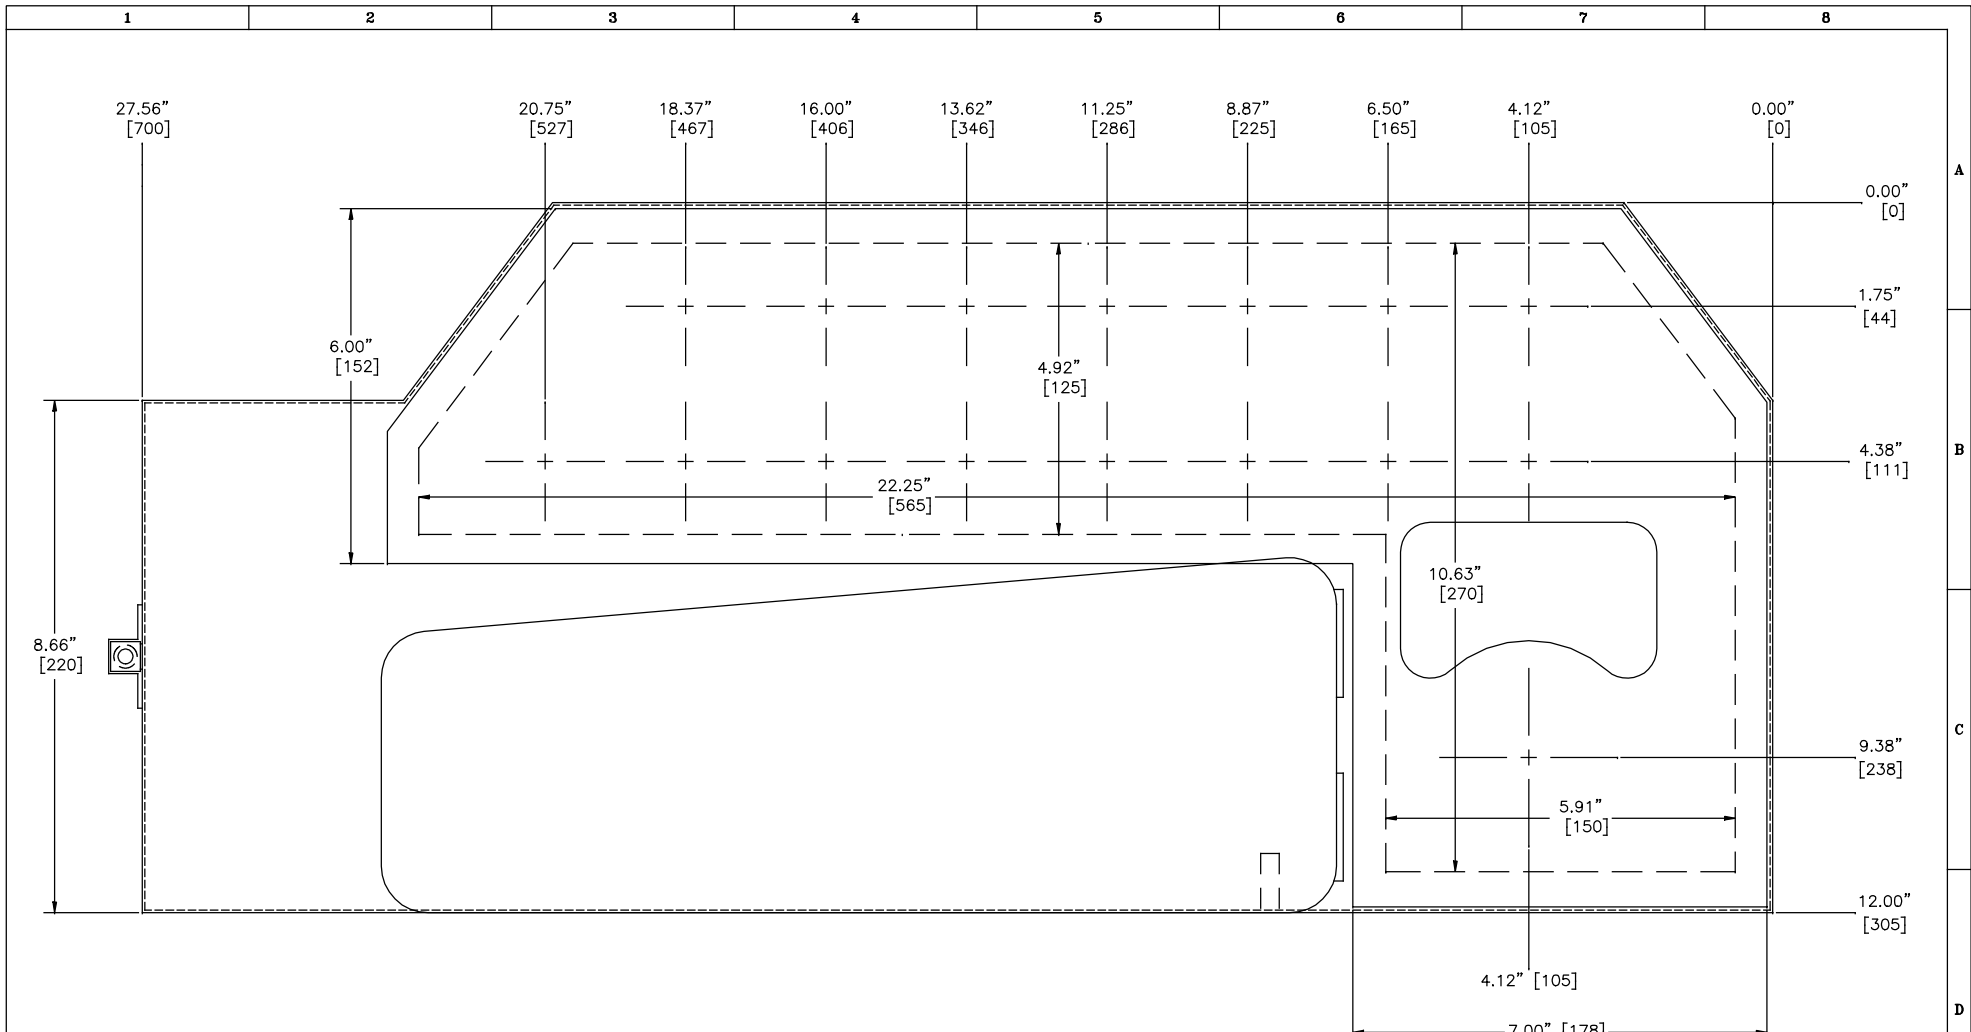

NOTES:
 1. MATERIAL - 14 GA STEEL
 2. FINISH - LIGHT GRAY POWDER COAT

THIS DRAWING IS FOR REFERENCE ONLY. IT IS A REPRESENTATION OF SPOHN DRAWING FSRHDG 653. NOT TO BE USED FOR MANUFACTURE.

REV	DATE	BY	ECR	DESCRIPTION	APPR	REV	DATE	BY	ECR	DESCRIPTION	APPR
01	01/14/16	KY	160.120	CHANGED WIDTH FROM 11.8 TO 12"	DB						
02	10/03/16	KY	378.951	UPDATED TO AS BUILT	DB						

	SCALE	1:2	CUSTOMER	J.R. MERRITT CONTROLS, INC.		
	DRAWN	KY	DATE	06/09/15	QUOTE	PROJECT
	CHECKED	DB	DATE	10/06/16	DESCRIPTION	REFERENCE
	APPROVED		DATE		FSRHDG 12" CONSOLE, LEFT	
<small>THIS DOCUMENT CONTAINS DATA WHICH IS CONFIDENTIAL AND PROPRIETARY TO JRMC INC. NO DISCLOSURE, REPRODUCTION, OR ANY USE OF ANY PART OF THIS DOCUMENT MAY BE MADE WITHOUT THE WRITTEN PERMISSION OF JRMC INC.</small>				DRAWING	B15.101.8314L	SHEET
				DATE	1 OF 1	REV
						02

8314L